

# Pedrom Tayefi

STREAM IDC (INDUSTRIAL DOCTORATE CENTRE FOR THE WATER SECTOR)

funded by the EPSRC

UNIVERSITY OF SHEFFIELD

WATER RESEARCH CENTRE (WRC)

SEVERN TRENT WATER

T: +44 (0) 7872 057 019

W: www.STREAM-IDC.net

E: pedrom.tayefi@STREAM-IDC.net


Job No: T/SK

Dwg No: 18A


Made By: PT

Title ULTRA-SOUND PROBE HOLDER


Date: 03/10/13

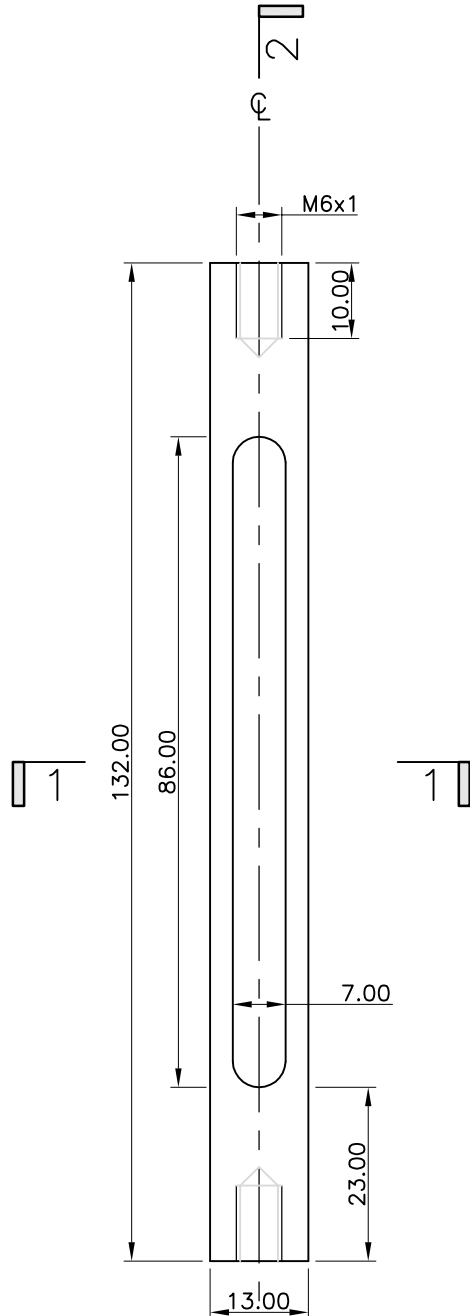

**GENERAL  
ARRANGEMENT**  
SCALE (1:1) @ A4

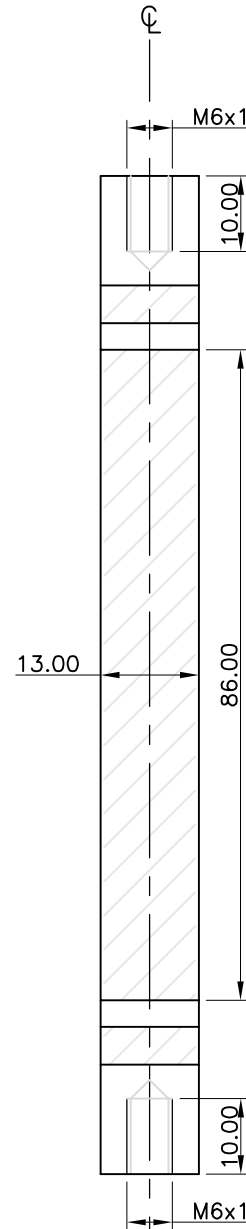

**SECTION 2 - 2**  
SCALE (1:1) @ A4

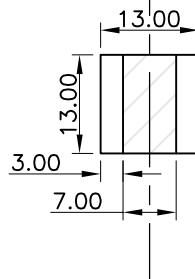

**SECTION 1 - 1**  
SCALE (1:1) @ A4

A	AMENDED G.A. TO SUIT AS-BUILT.	03/10/2013 (PT)
SUFFIX	REVISIONS	DATE